


Key

▭	Limits v.6
▭	Limits v8.2

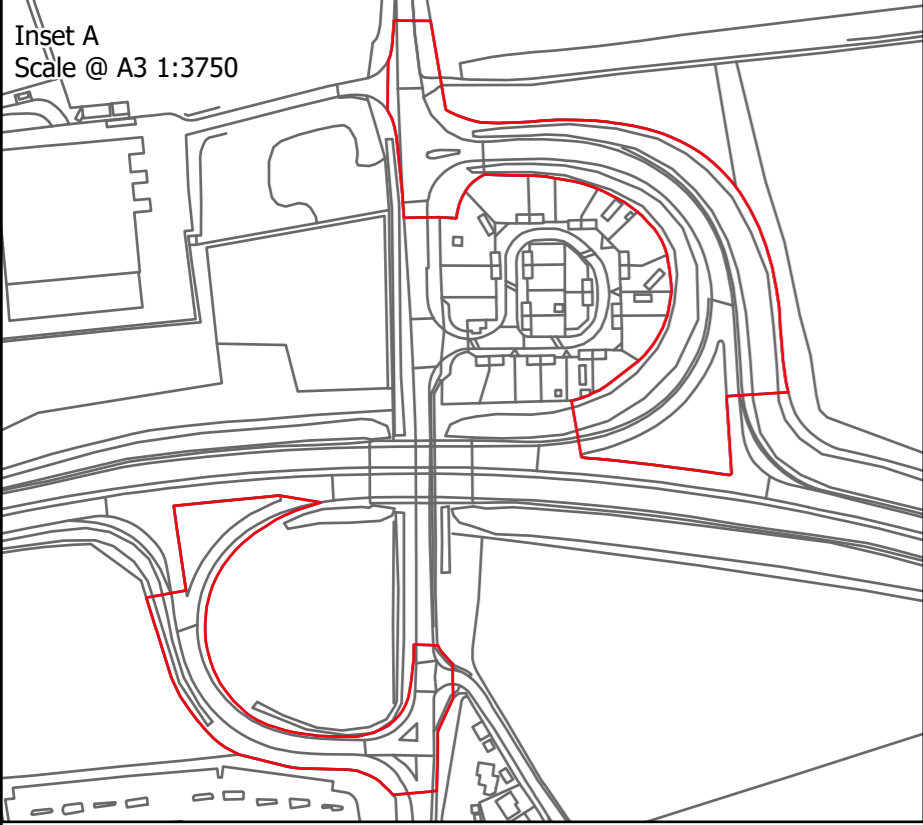

A	AG	JH	SA	09/08/2025
REVISION	DRAWN	CHECKED	APPROVED	DATE

SCALE: 1:20,000
0 250 500 Metres

© Crown copyright and database rights 2025.
Ordnance Survey 0100031673

PROJECT TITLE
THE DROVES SOLAR FARM

DRAWING TITLE
Red Line Boundary Change Plan

DRAWING STATUS
FOR INFORMATION ONLY

DRAWN	CHECKED	APPROVED	AUTHORISED
AG	JH	SA	SA
SCALE @ A1 SIZE	DATE	REVISION	
1:20,000	09/08/2025	A	

DRAWING NUMBER
UK0037735.5772-RLBChange-0002